


1 March 1983
AS CONSTRUCTED 20 JUNE 1984
1200

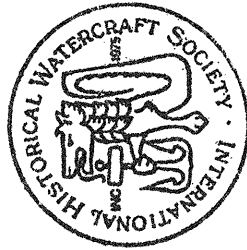

The
Dana Point
California

FOR
THE NAUTICAL HERITAGE MUSEUM AT DANA POINT


by
MELBOURNE SMITH
INTERNATIONAL HISTORICAL WATERCRAFT SOCIETY, INC.
DESIGNERS & BUILDERS, P.O. BOX 54, ANNAPOLIS MARYLAND 21404

DESIGN NO: 801
1/64 SCALE
3/16" = 1 FOOT

0665-7
CALIFORNIA
FILED 11-5

© 1984 MELBOURNE SMITH

PLATE VI: SPARS & RIGGING

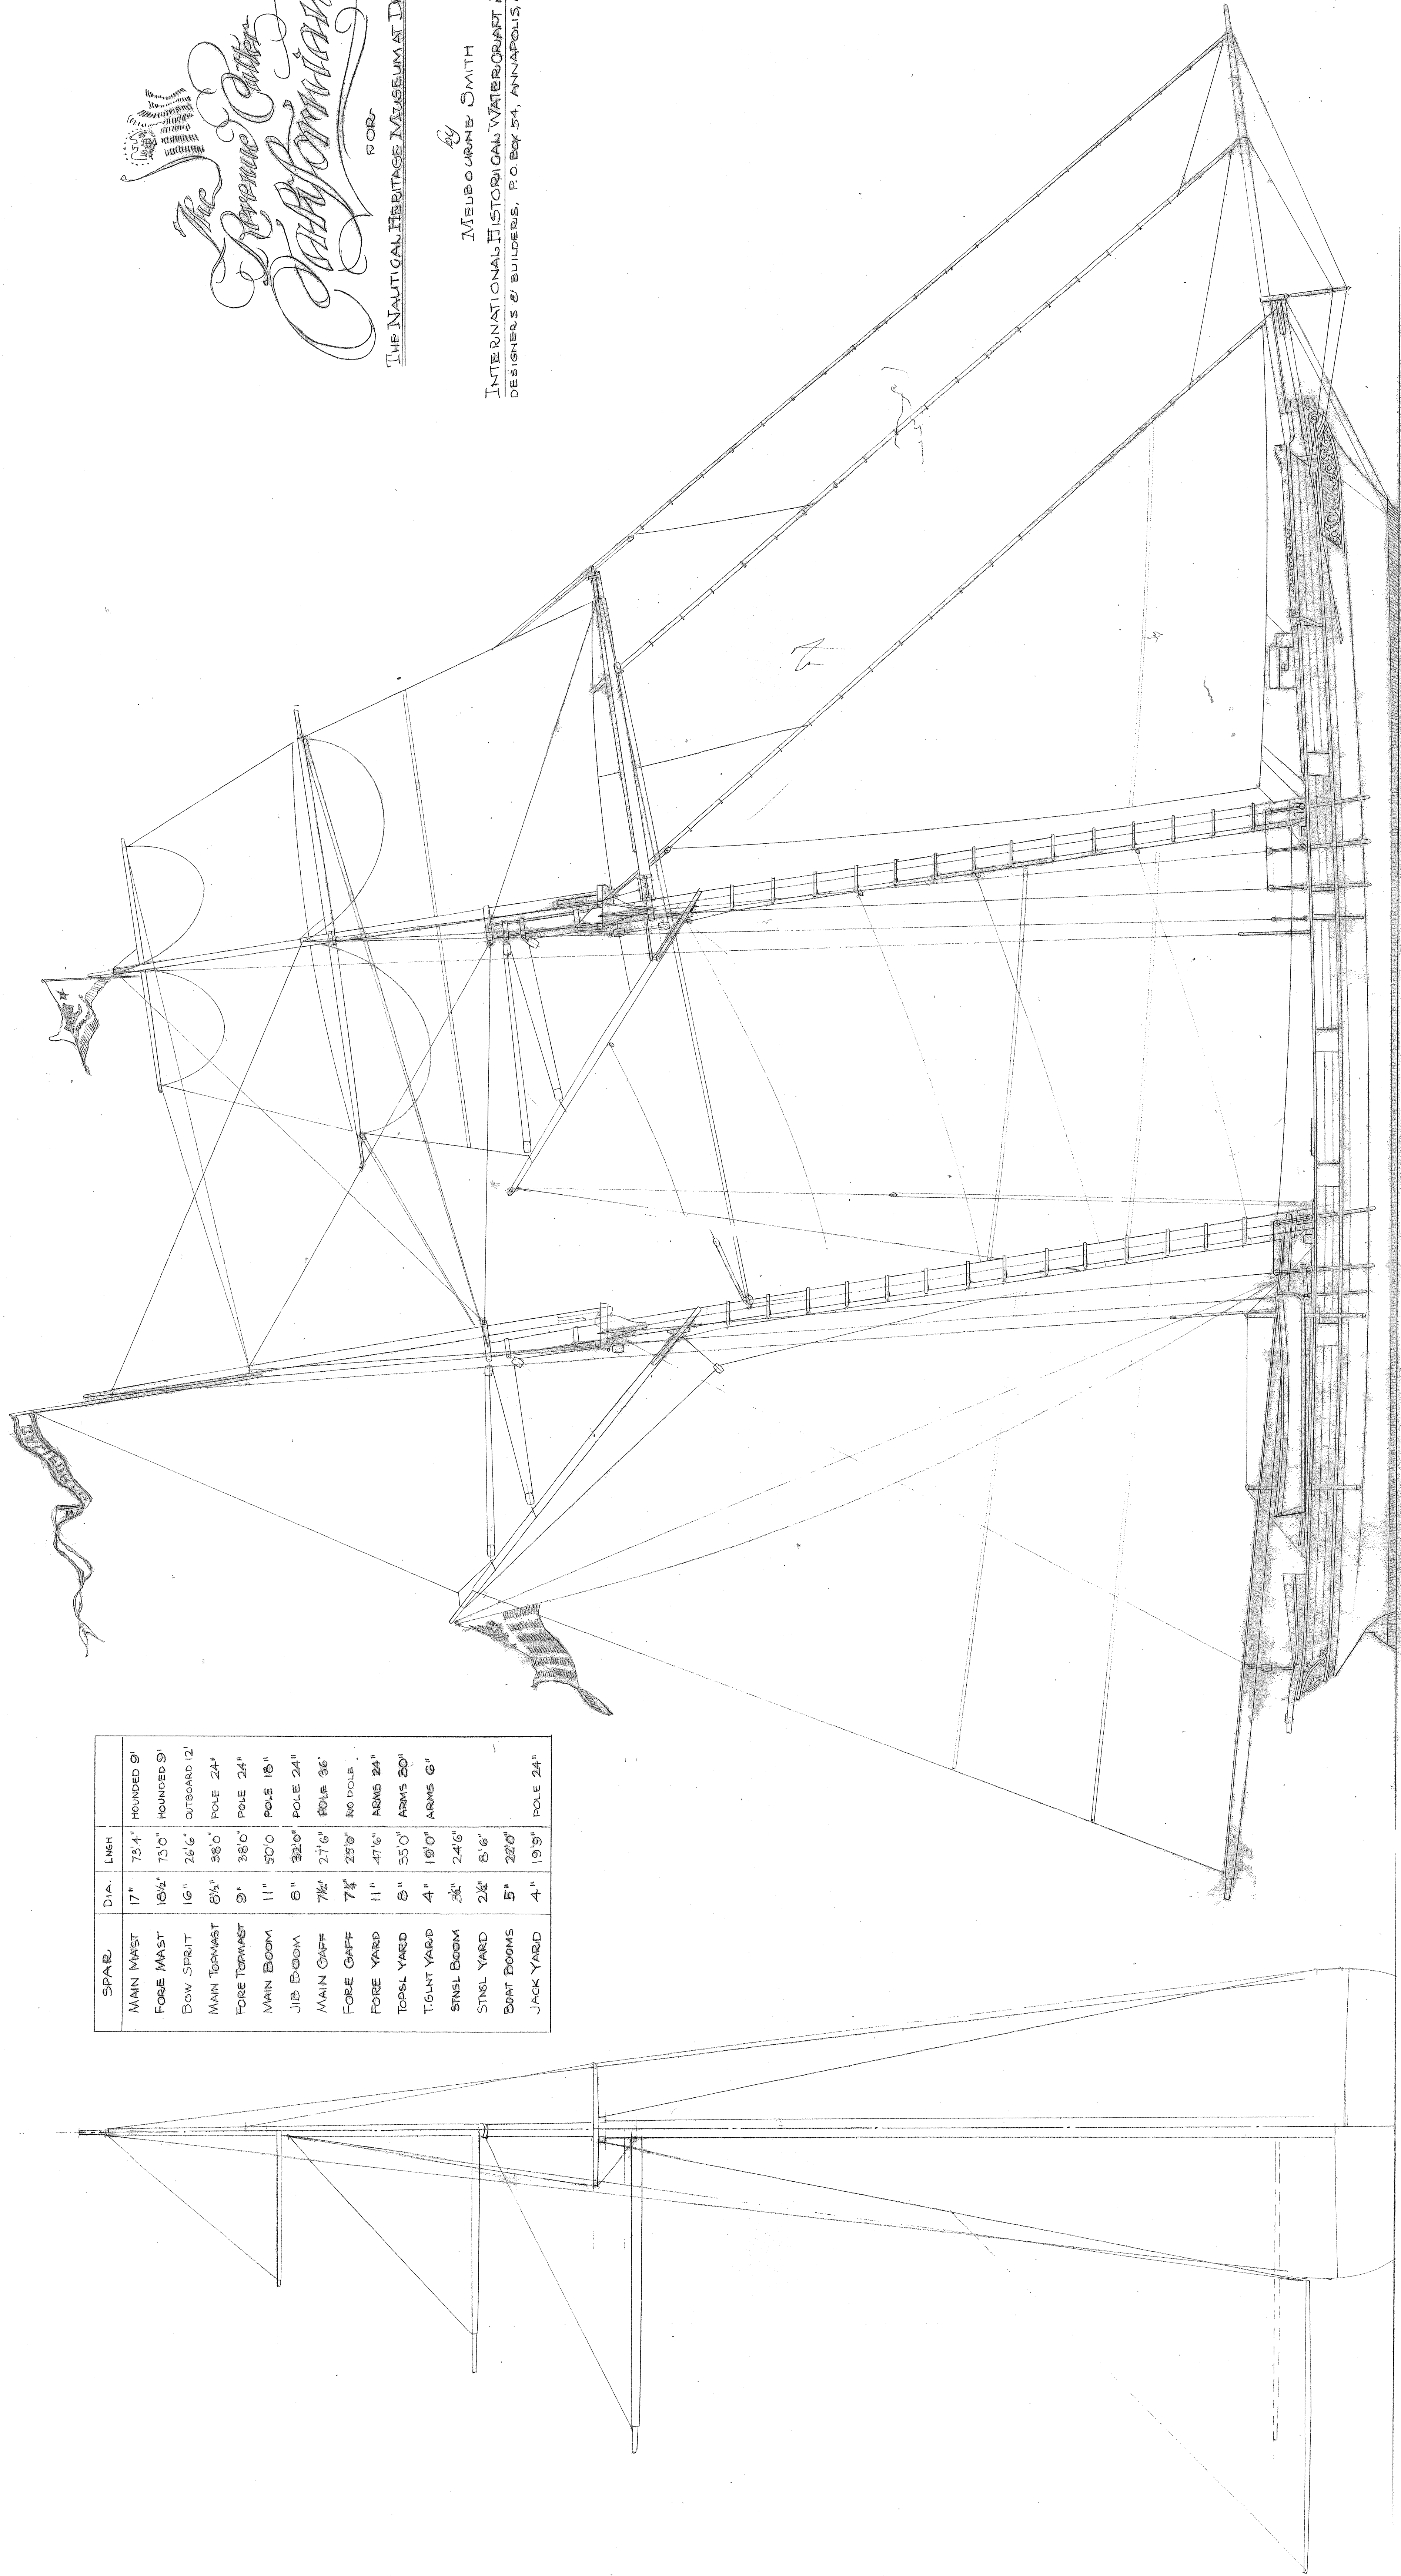

SPAR	DIA.	LGTH	REMARKS
MAIN MAST	17"	73'4"	HOUNDED 9'
FORE MAST	15 1/2"	73'0"	HOUNDED 9'
BOW SPRIT	16"	26'6"	OUTBOARD 12'
MAIN TOPMAST	9 1/2"	38'0"	POLE 24"
FORE TOPMAST	9"	38'0"	POLE 24"
MAIN BOOM	11"	50'0"	POLE 18"
JIB BOOM	8"	32'0"	POLE 24"
MAIN GAFF	7 1/2"	27'6"	POLE 36"
FORE GAFF	7 1/2"	25'0"	NO POLE
FORE YARD	11"	47'6"	ARMS 24"
TOPSEL YARD	8"	35'0"	ARMS 20"
TIGLIT YARD	4"	19'0"	ARMS 6"
SINSL BOOM	3 1/2"	24'6"	
SINSL YARD	2 1/2"	8'6"	
BOAT BOOMS	5"	22'0"	
JACK YARD	4"	19'9"	POLE 24"