



1 March 1983
AS CONSTRUCTED 30 JUNE 1984

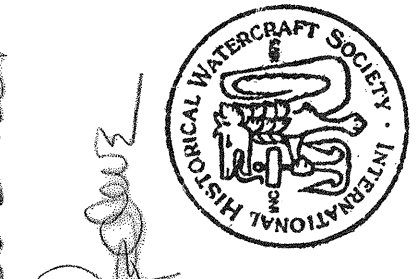

*The Revenue Cutter
Cahoon*
FOR
THE NAUTICAL HERITAGE MUSEUM AT DANA POINT

by
MELBOURNE SMITH
INTERNATIONAL HISTORICAL WATERCOAST SOCIETY, INC.
DESIGNERS & BUILDERS, PO BOX 54, ANNAPOLIS, MARYLAND, 21404

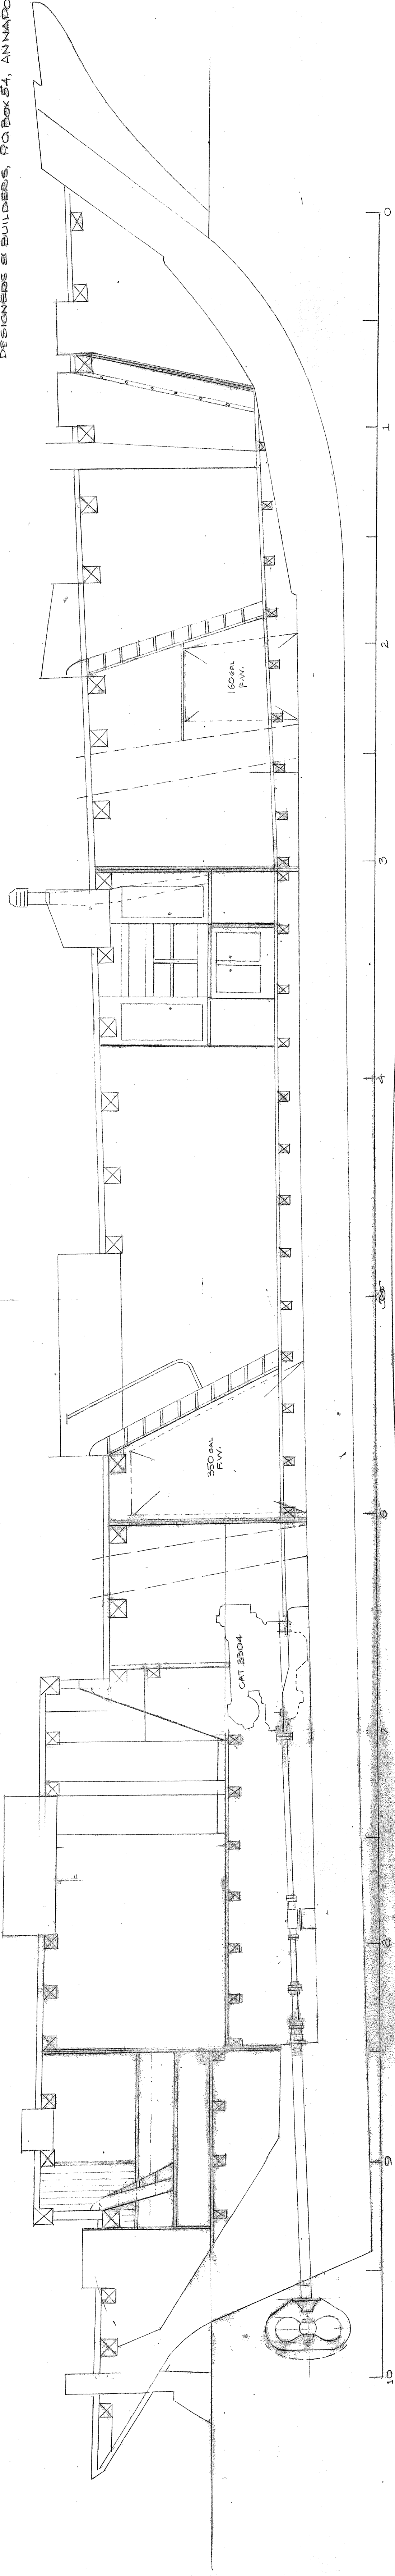

DESIGN NO: 831
1:32 SCALE
3/8" = 1 FOOT

