

20 March 1983
AS CONSTRUCTED 30 JUNE 1984

1600





The
Revenue Cutter
CALIFORNIA

FOU

THE NAUTICAL HERITAGE MUSEUM AT DANA POINT

by
MELBOURNE SMITH

INTERNATIONAL HISTORICAL WATERCRAFT SOCIETY, INC.
DESIGNERS & BUILDERS 30 BOYSA, ANNAPOLIS, MARYLAND 21404

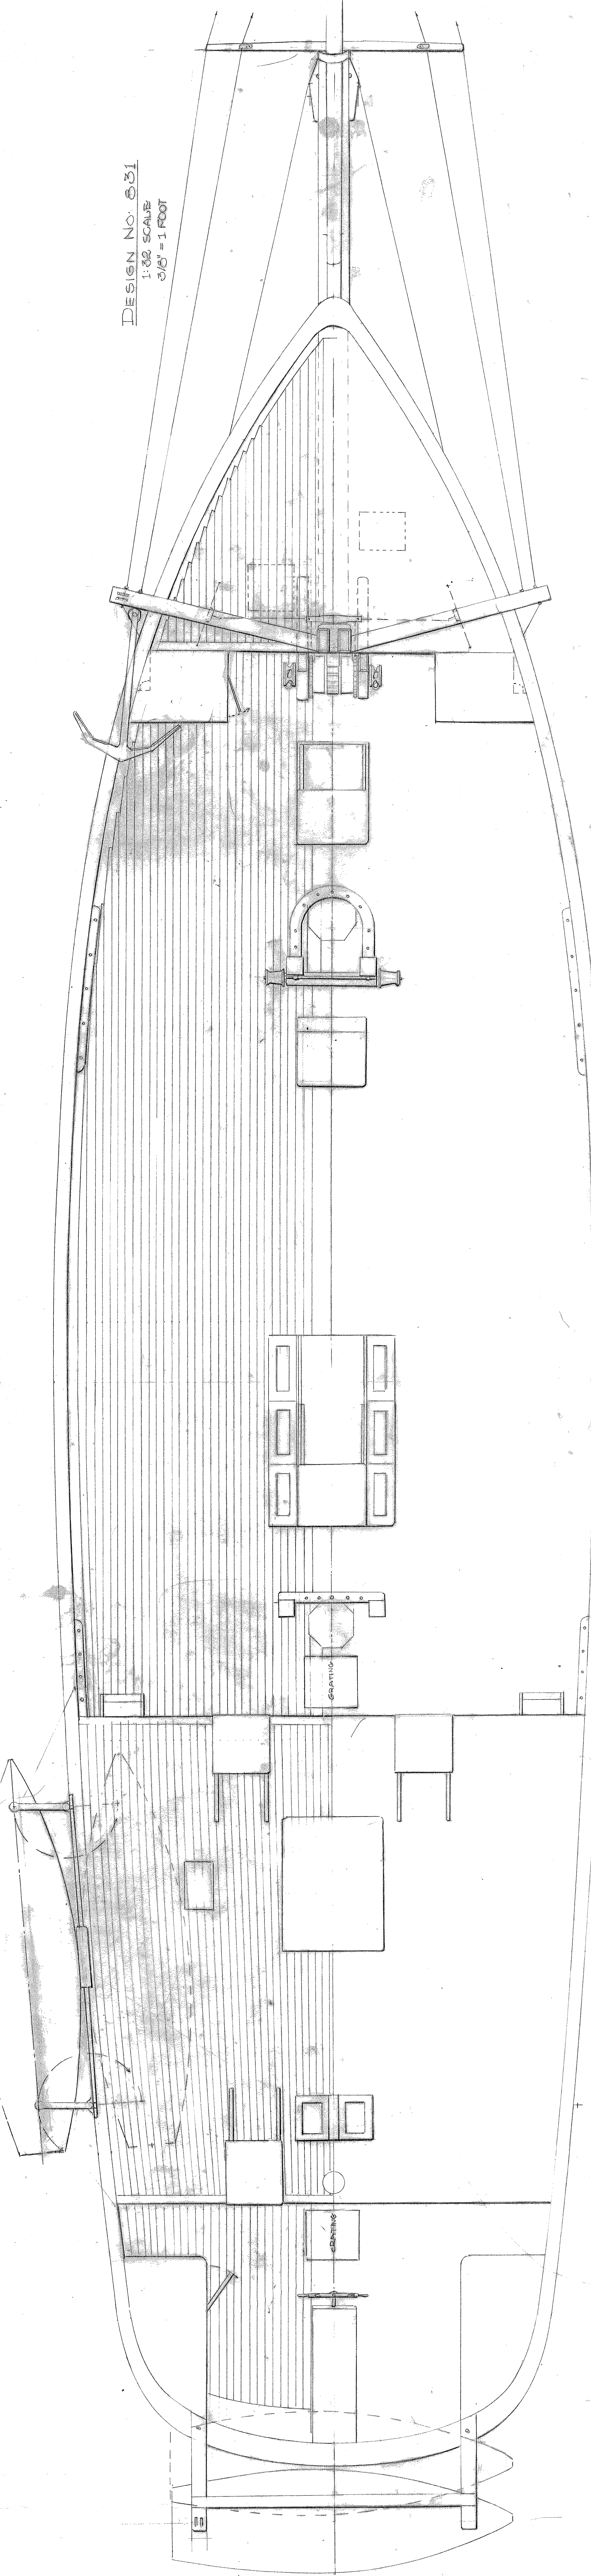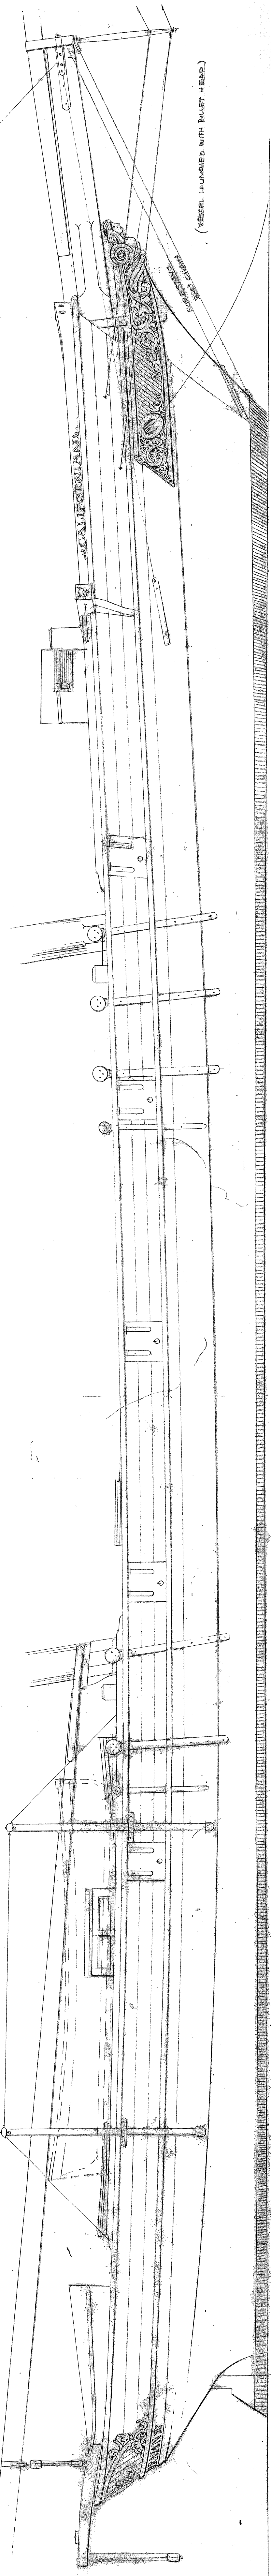

0665-3
CH. 10111111
Fol. 16 Dna. 5

PLATE III: SHEER & DECK