




20 March 1983
AS CONSTRUCTED 30 JUNE 1984

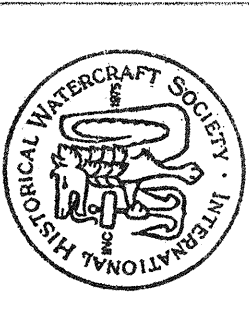

*The
Reverend Captain
Philip Morrison*

FOR
THE NAUTICAL HERITAGE MUSEUM AT DANA POINT

by
MELBOURNE SMITH
INTERNATIONAL HISTORICAL WATERCRAFT SOCIETY, INC.
DESIGNERS & BUILDERS, PO BOX 58, ANNAPOLIS, MARYLAND, 21404

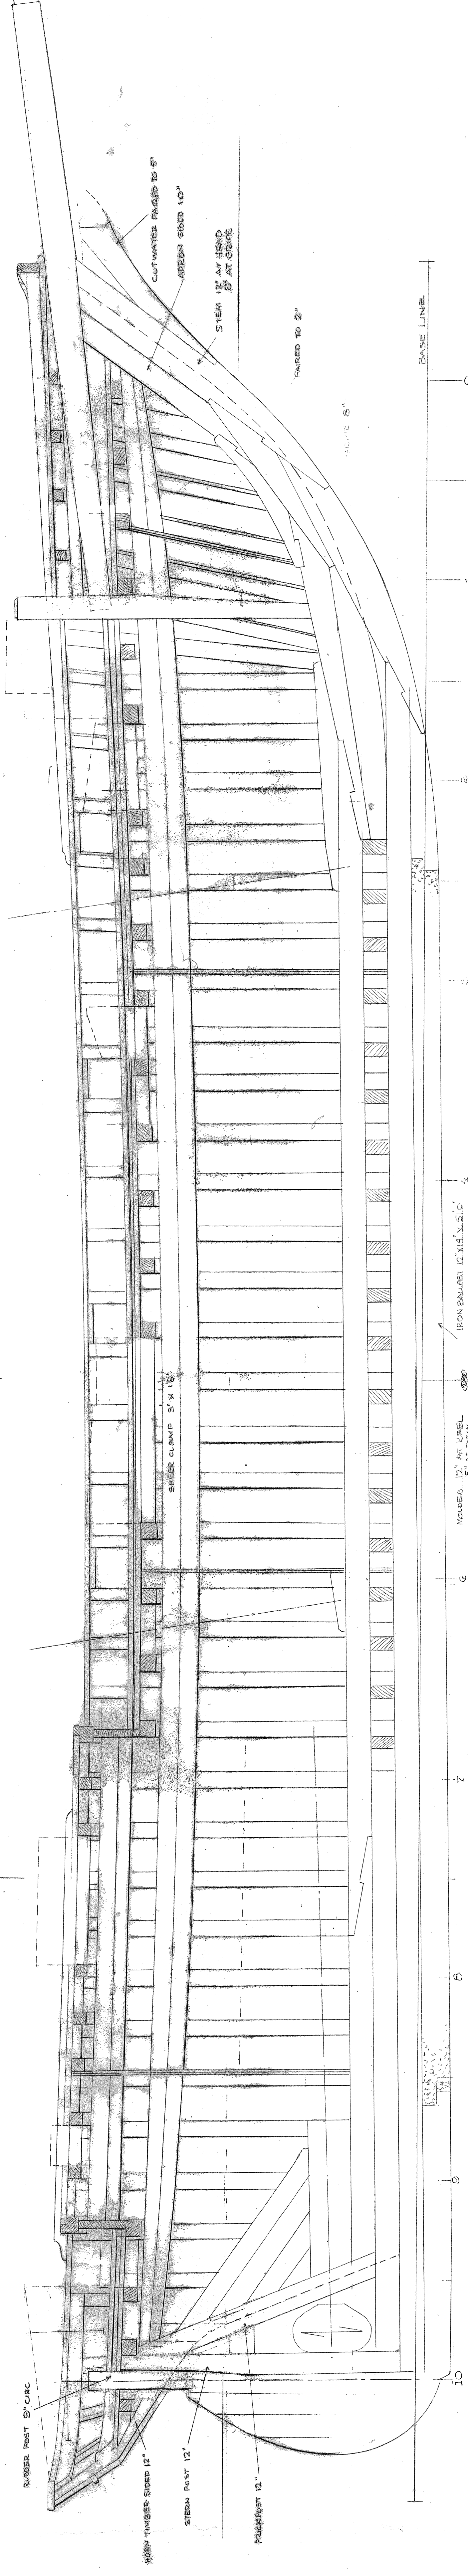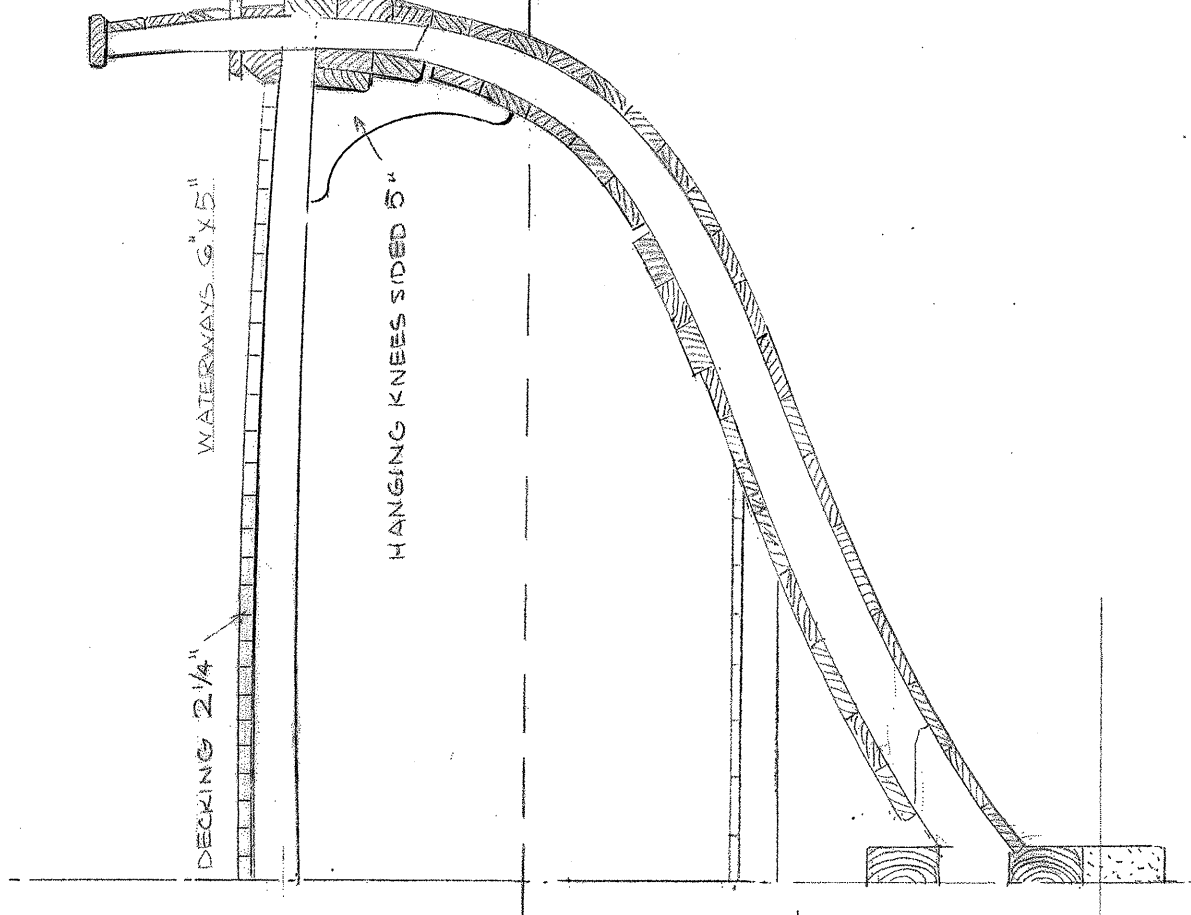

DESIGN NO. 881
1:32 SCALE
3/8" = 1 FOOT

