


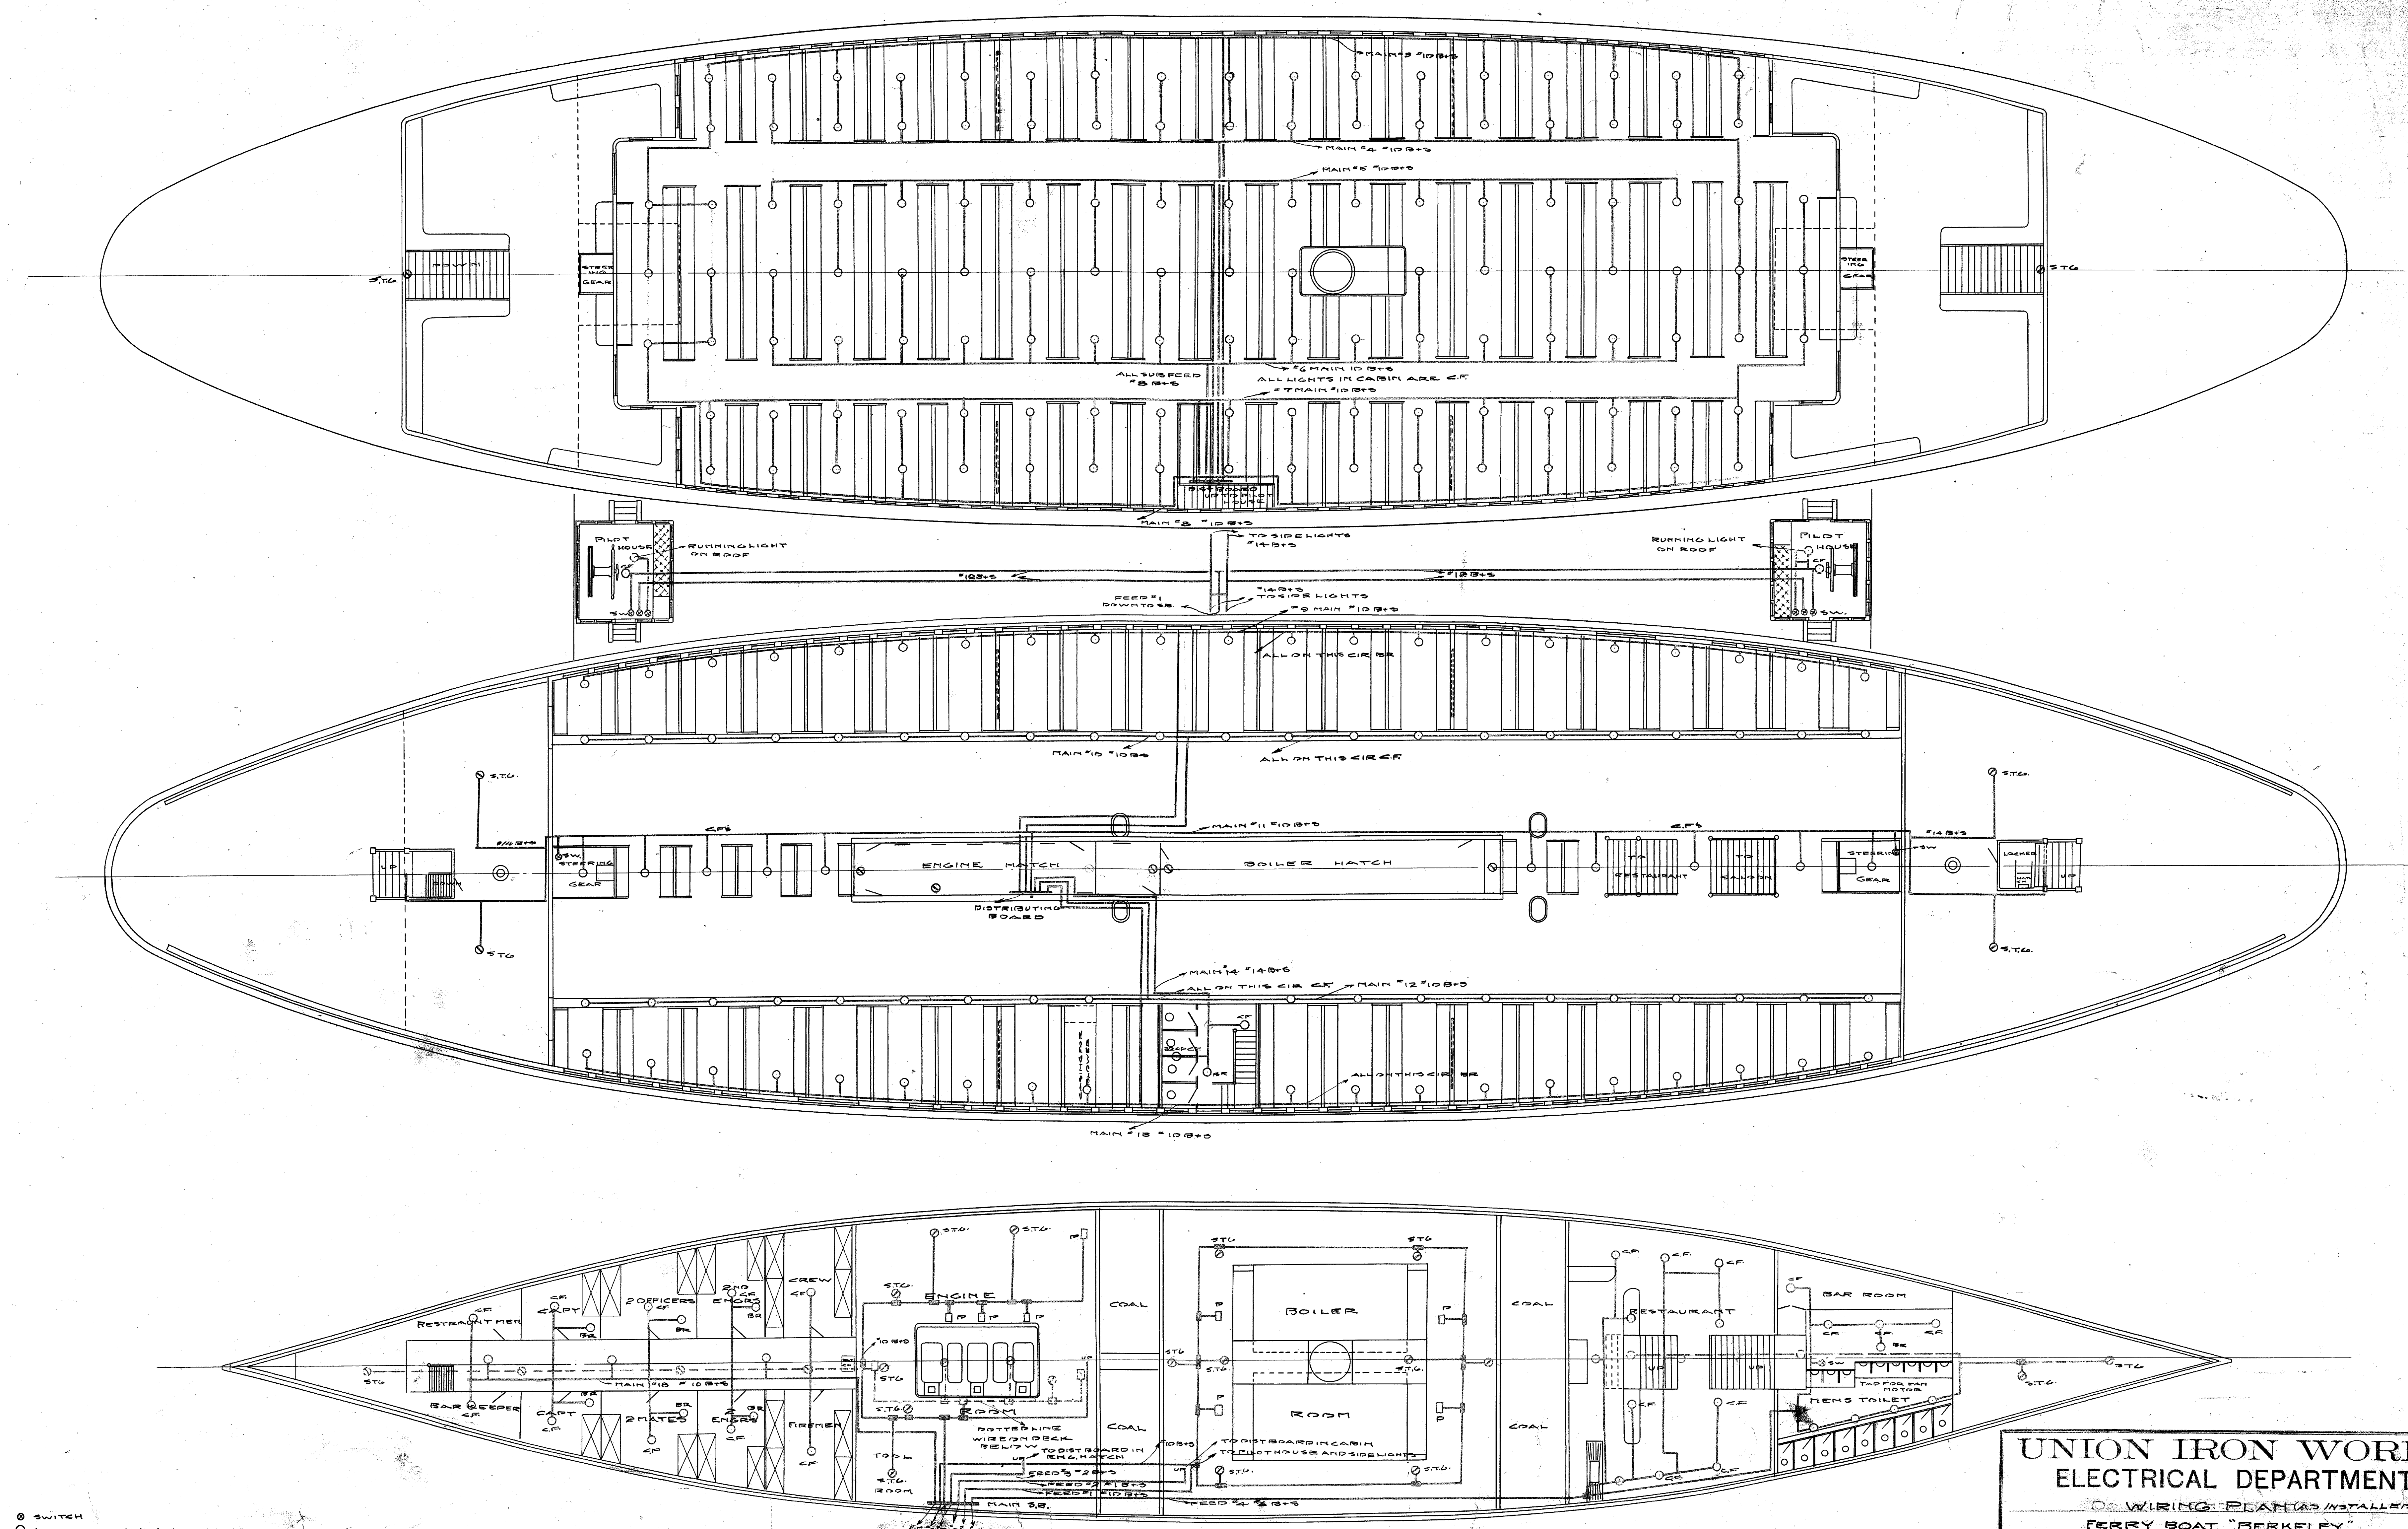

- SWITCH
- LIGHT-CEILING FIXTURE-TR. BRACKET
- STG STEAM TIGHT LOOSE
- F FUSE
- P PORTABLE LAMP

UNION IRON WORKS ELECTRICAL DEPARTMENT. WIRING PLANS (AS INSTALLED) FERRY BOAT "BERKELEY"			
CASE No.	SCALE: 1/4" = 1'-0"	SHEET No.	
ORDER No.	DATE	DESIGNED AND CONSTRUCTED FOR	APPROVED BY
1548	SEPT 98	S.P.C.O.	

0341-4
Berkeley
SEP 2