SHEET NOTES: (APPLICABLE TO THIS SHEET & SHT. A4.2)

1. SURFACES & FINISHES OF NEW &/OR ALTERED CONSTRUCTION TO MATCH ADJACENT SURFACES & FINISHES.
2. RESTORE ASSEMBLIES & FINISHES DISRUPTED OR DAMAGED DURING CONSTRUCTION.
3. ~~(E) LOCKER RM. SHEET FLOORING TO REMAIN EXCEPT AT (N) RAMP.~~
4. EXISTING LIGHTING CIRCUITS & LIGHT FIXTURES TO REMAIN; SEE NOTES ON PLAN RE FIXTURES AT NEW SKYLIGHTS.
5. PLYW'D. OVER 2" SLEEPERS. REMOVE EXISTING SHT. VINYL FLOORING PRIOR TO CONSTRUCTION. ALIGN SLEEPERS OVER FLOOR JOISTS BELOW. (RAMP TO BE CONSTRUCTED OF 3/4")
6. PRIOR TO CONSTRUCTION OF LOCKER BASES OR RAISED FLOOR, CONVENE A MEETING WITH THE DOLPHIN CLUB BOATHOUSE CAPTAIN & THE ARCHITECT TO REVIEW LOCKER LAYOUTS; SEND NOTICE OF MEETING TIME MIN. 3 BUSINESS DAYS IN ADVANCE.
7. ~~REFER TO SPECIFICATION SECTION 16000 - ELECTRICAL FOR LIGHT FIXTURE SCHEDULE.~~

LOCKERS INCLUDED IN CONTRACT

LOCKERS INCLUDED IN CONTRACT

LOCKER SCHEDULE:

NOTE: ALL LOCKERS ARE ON-SITE. REFER TO SHT. SK.5.1 FOR THE ARRANGEMENT OF SETS OF LOCKERS.

	TYPE	TOTAL	DESCRIPTION
	A	304	METAL; 1'-0"W x 3'-0"H x 1'-6"D; DOUBLE HEIGHT SETS OF 2 THRU 7
	B	12	WOOD; 1'-4"W x 5'-0"H x 1'-8"D; SINGLE HEIGHT; 3 SETS OF 4.
	C	10	WOOD; 1'-4"W x 4'-0"H x 1'-8"D; DOUBLE HEIGHT; 1 SET OF 10
	F	4	METAL; 1'-0"W x 6'-0"H x 1'-6"D; SINGLE HEIGHT; GROUP OF 4
10	TOTAL LOCKERS:	330	
	ACCESSIBLE LOCKERS:	34 / 10% OF TOTAL	

SEE SHT. A4.3 FOR ADD'L. LOCKER DETAILS.

SHEET NOTES: (CONT'D.)

13. INSTALL 1/2" (MIN.) PLYWD. CAPS TO 2" BLK'G. AT TOP OF ALL FILLER SPACES. (MARKED BY AN "X")

GENERAL NOTES: APRIL 9, 2010

1. THE SCOPE OF THIS WORK IS THE REPLACEMENT-IN-KIND OF THE METAL LOCKERS IN THE 2nd FLOOR WOMENS LOCKER ROOM.
2. THIS PLAN IS REFERENCED FOR THE ARRANGMENT OF THE LOCKERS ONLY (NO OTHER WORK IS INCLUDED).

SHEET INDEX

H-1 DA CHECKLIST (1of2)
H-2 DA CHECKLIST (2of2)
A4.1 FLOOR PLAN & PATH OF TRAVEL
A4.3 LOCKER DETAILS

AREA OF WORK

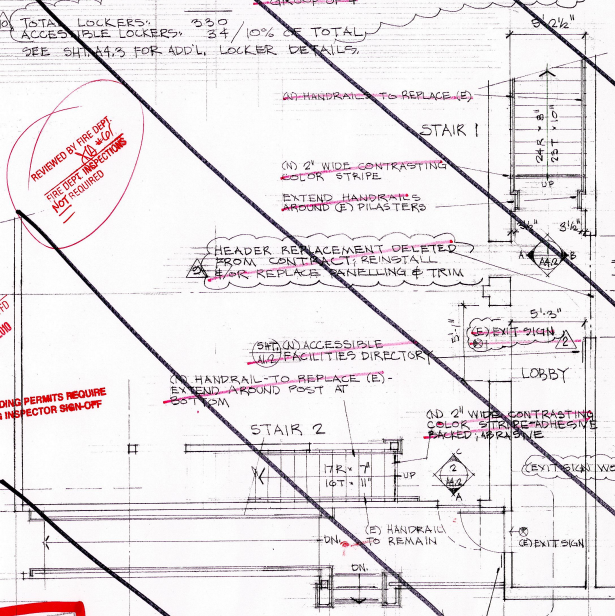

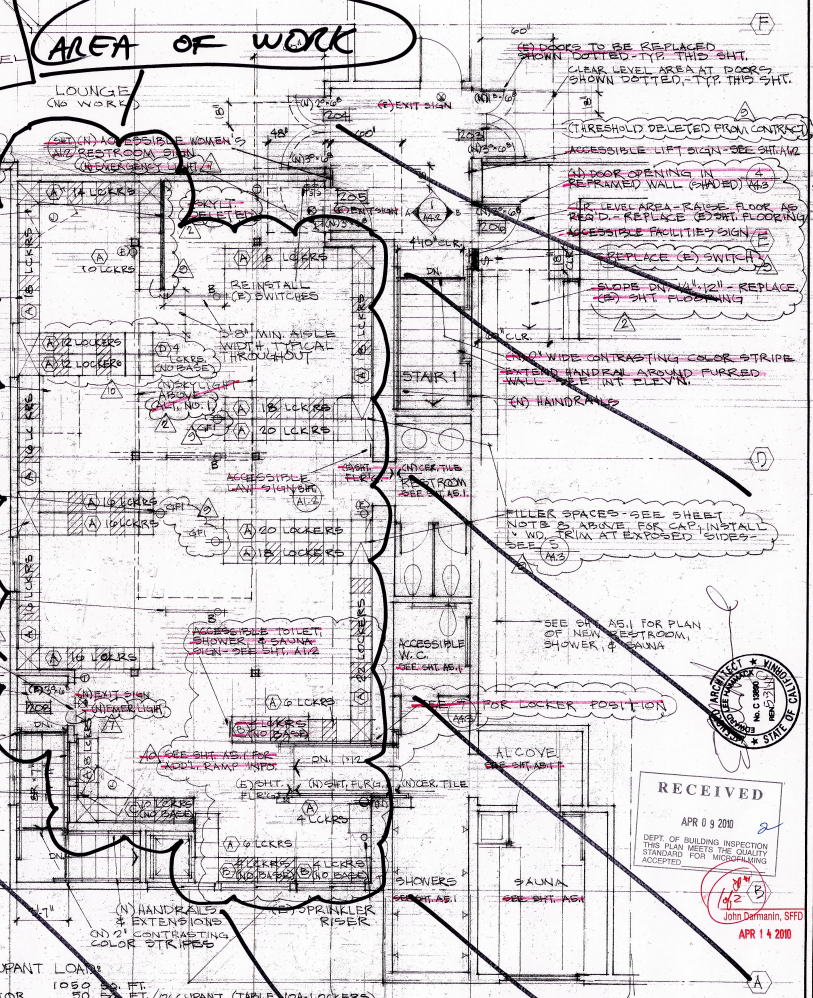

STAIR 2 OCCUPANT LOAD

AREA SERVED:	1050	SQ. FT.
÷ OCC. LOAD FACTOR	50	SQ. FT./OCCUPANT (TABLE 10A-LOCKERS)
TOTAL OCCUPANTS	21	
÷ NO. OF EXITS	2	
OCCUPANT LOAD	11	< 49 = MIN. STAIRWAY WIDTH = 3'-0" (SEC. 1006.2)

(E) ACCESSIBLE FACILITIES IDENTIFICATION SIGN
SEE SHT. R4 FOR PLAN & DETAILS OF (E) ACCESSIBLE ENTRY

1 GROUND FLOOR - ENTRY & PATH OF TRAVEL

2 SECOND FLOOR - NEW LOCKERS

SCALE: 1/4" = 1'-0"

PERMIT NUMBER 2010 04/09 99985 REVIEWED
For Compliance with City and County Ordinances and State Codes.
The stamping of this plan and these specification SHALL NOT be held to permit or to be an approval of the violation of any City and County Ordinance or State Law.
Approval is subject to the inspection by the Fire Department.
These plans must be kept on the premises and accessible to the inspector at all times.
John Darmanin, SFFD APR 14 2010

REVIEWED BY FIRE DEPT. FIRE DEPT. INSPECTIONS NOT REQUIRED

ALL BUILDING PERMITS REQUIRE BUILDING INSPECTOR SIGN-OFF

PLEASE NOTIFY FIRE INSPECTOR AT THE START OF WORK 558-3300

Call 415-558-6570, to schedule inspections. For building, electrical and / or plumbing, this application is approved without site inspection, detailed plumbing or electrical plan review and does not constitute an approval of the building. Work authorized must be done in strict accordance with all applicable codes. Any electrical or plumbing work shall require appropriate separate permits.
APR 14 2010

RECEIVED APR 09 2010 DEPT. OF BUILDING INSPECTION THIS PLAN MEETS THE QUALITY STANDARD FOR MICROFILMING ACCEPTED
John Darmanin, SFFD APR 14 2010

REVISIONS	BY
1 REVISIONS TO NOV. 98	
2 CONT. DOCS. 26 APR. 99	
3 EMER. LIGHTS 17 NOV. 99	
4 MISC. 1 DEC. 99	
5 MISC. 21 JAN. 00	

DOLPHIN SWIMMING & BOATING CLUB
SAN FRANCISCO 94122 JEFFERSON ORGANIZED 1877
LOCKER ROOM & SHOWER EXPANSION

EDWARD LEE HAMMACK ARCHITECT
CA Reg. no. C-12899
3207 Fillmore Street San Francisco, CA 94123 415.292.4428

LARGE SCALE PLANS - FIRST FLOOR/PATH OF TRAVEL & SECOND FLOOR/NEW LOCKERS, LOCKER SCHEDULE

Date PERMIT @ JUNE 07
Scale AS NOTED
Drawn
Job
Sheet A4.1 Of Sheets

2010/0409/9985