Files in Railroad Cabinet - Drawer L-5

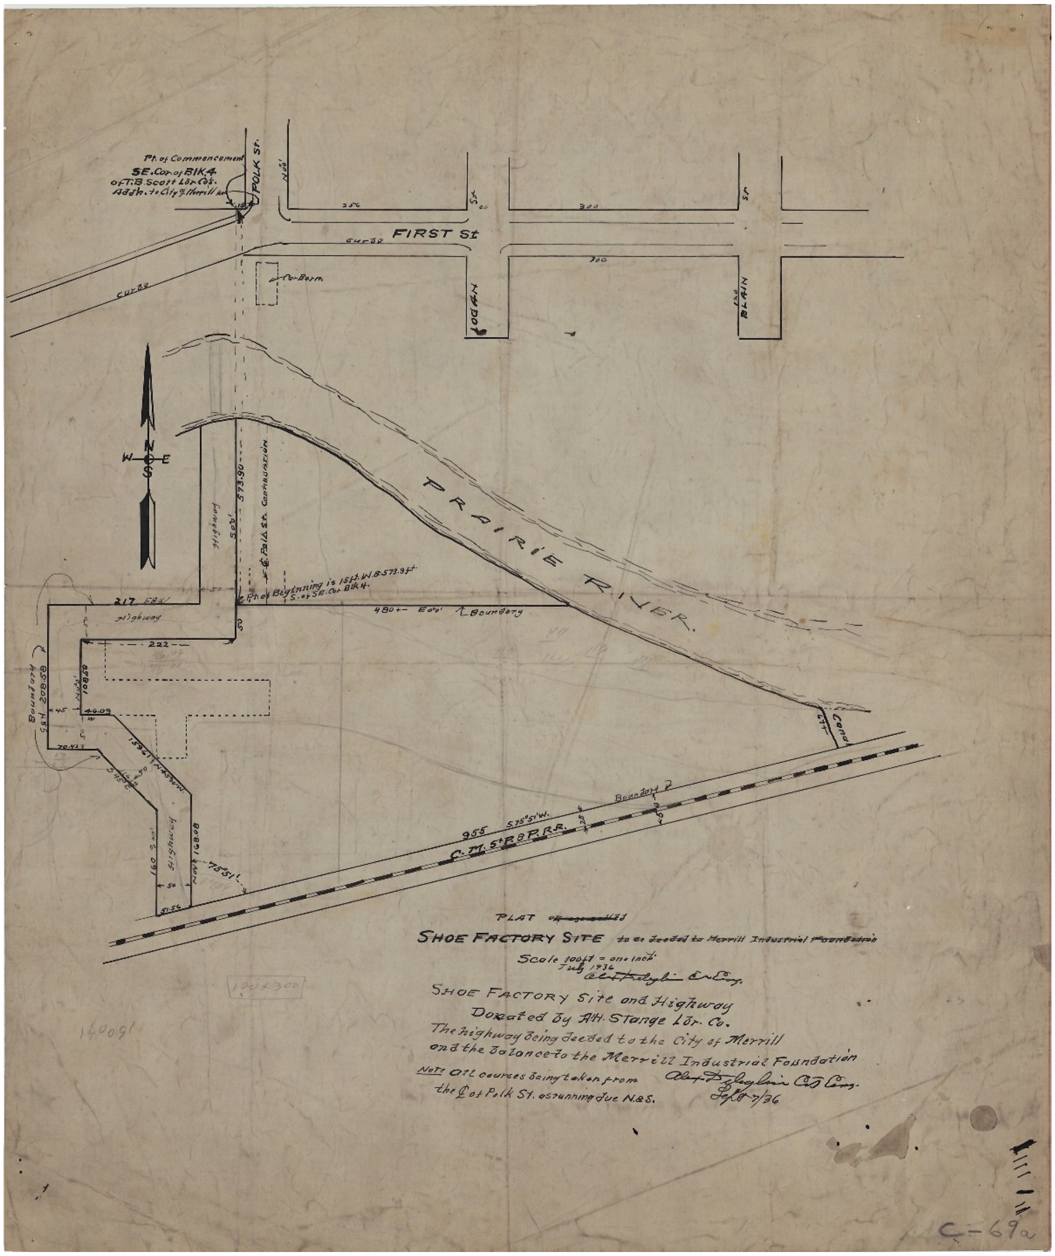

PLAT ~~of a so-called~~

SHOE FACTORY SITE ~~to be deeded to Merrill Industrial Foundation~~

Scale 100 ft = one inch
July 1936
Alex Dzeglin C.E. Eng.

SHOE FACTORY Site and Highway
Donated by A.H. Stange Lbr. Co.
The highway being deeded to the City of Merrill
and the balance to the Merrill Industrial Foundation

Note: all courses being taken from the ℄ of Polk St. as running due N. & S.

Alex Dzeglin C.E. Eng.
Sept. 7/36

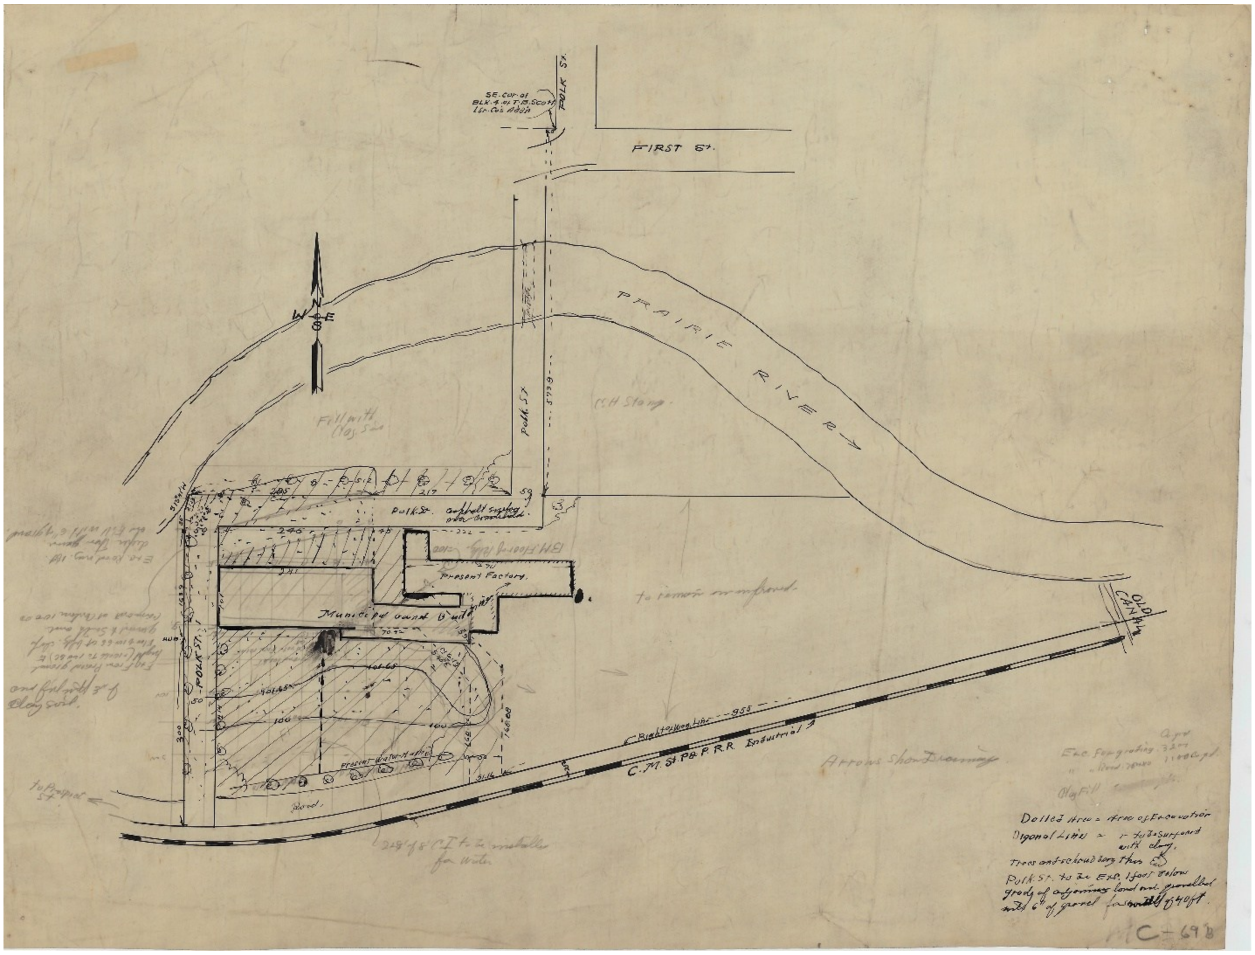

Dotted Area = Area of Excavation
Diagonal Lines = " to be surfaced with clay.
Trees and shrubbery thus
Polk St. to be Exc. 1 foot below grade of adjoining land and gravelled with 6" of gravel for width of 40 ft.

C-69B

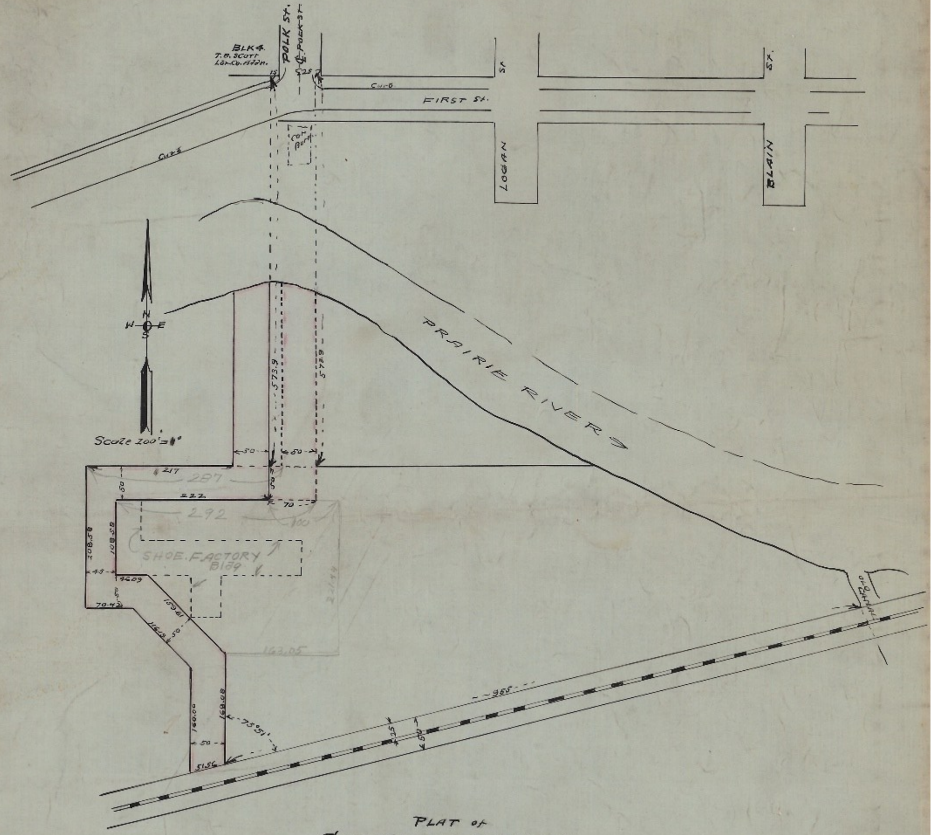

PLAT of

SHOE FACTORY HIGHWAY

if Put West of CAR BARN

Scale 100 ft - one inch

Cat Eng Jul 1936

Note. Dotted Lines show Highway thru Car Barn Site.

C-69

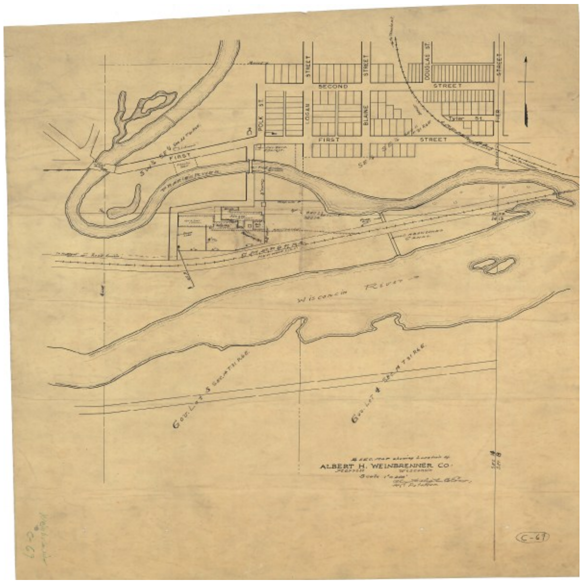SECOND
STREET
FIRST
STREET
POLK ST.
LOGAN
STREET
BLAINE
STREET
DOUGLAS ST.
Tyler St.
PIER
STREET
FIRST
PRAIRIE RIVER
Wisconsin River
Gov. Lot 3 Sec. 14 T31 R6E
Gov. Lot 4 Sec. 14 T31 R6E
Abandoned Canal
¼ Sec. map showing location of
ALBERT H. WEINBRENNER CO.
MERRILL WISCONSIN
Scale 1"=200'
C-69

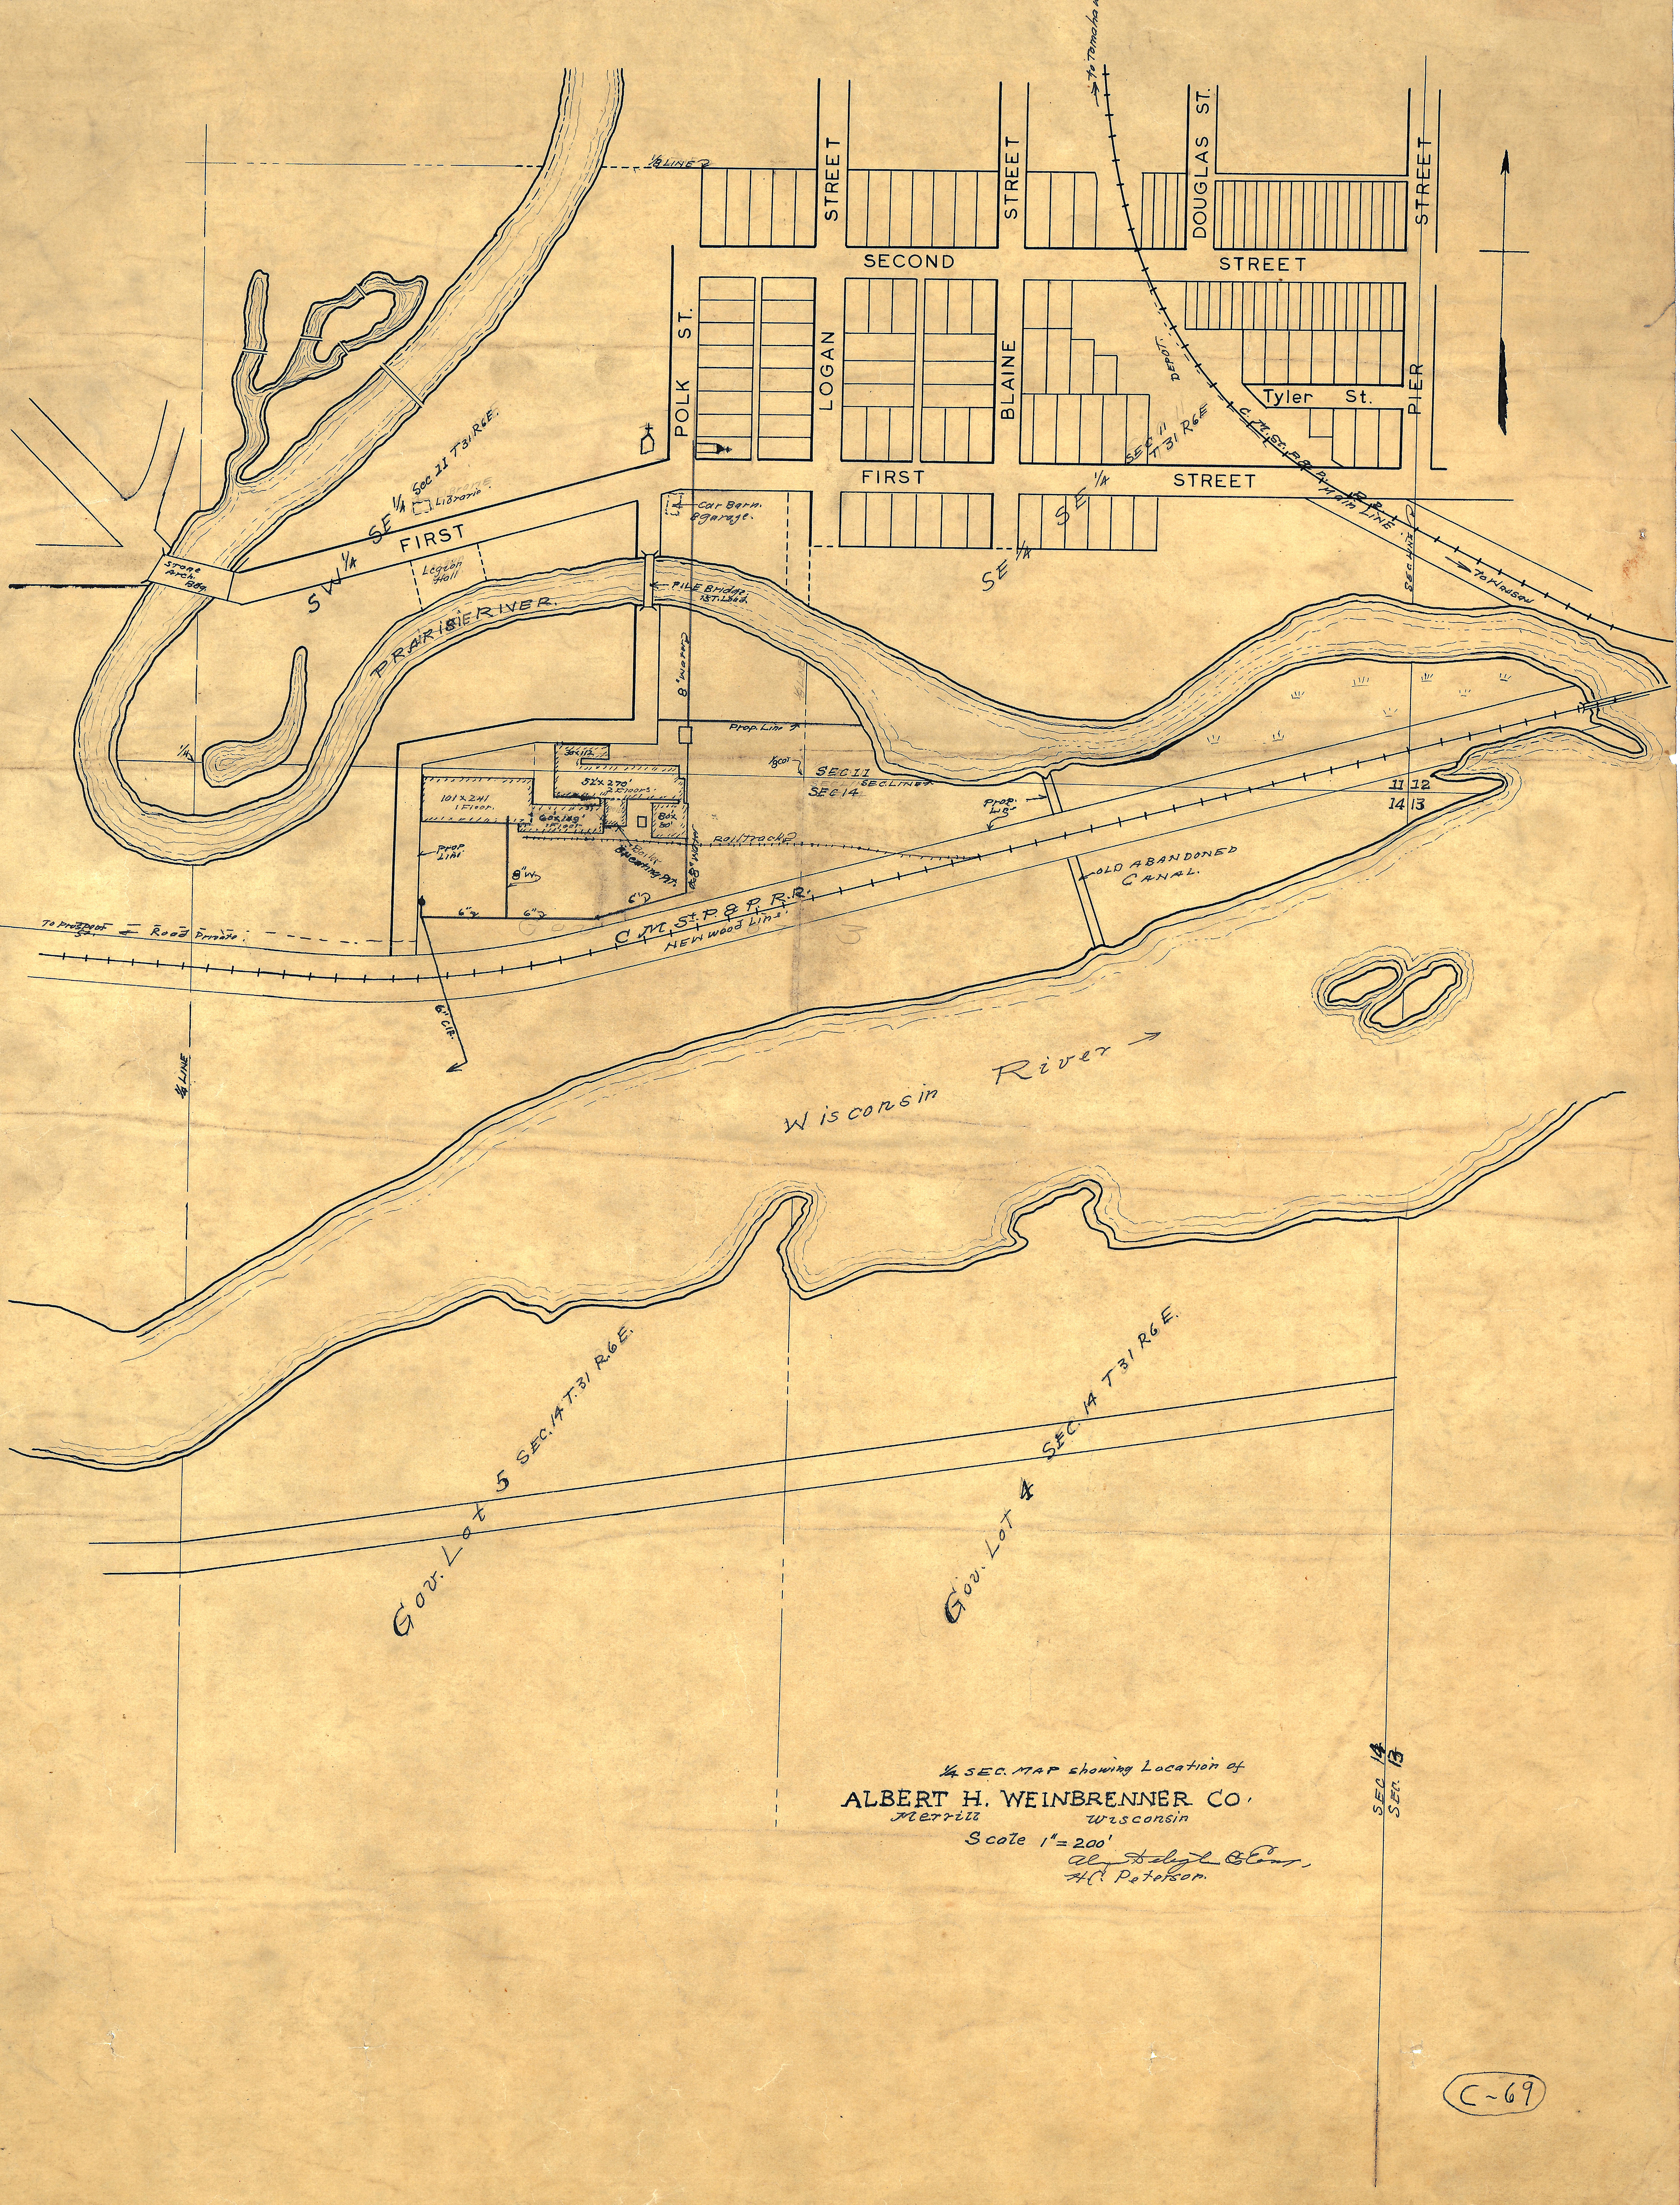

¼ SEC. MAP showing Location of

ALBERT H. WEINBRENNER CO.

Merrill Wisconsin

Scale 1" = 200'

H.C. Peterson.

C-69

Weinbrenner C-69

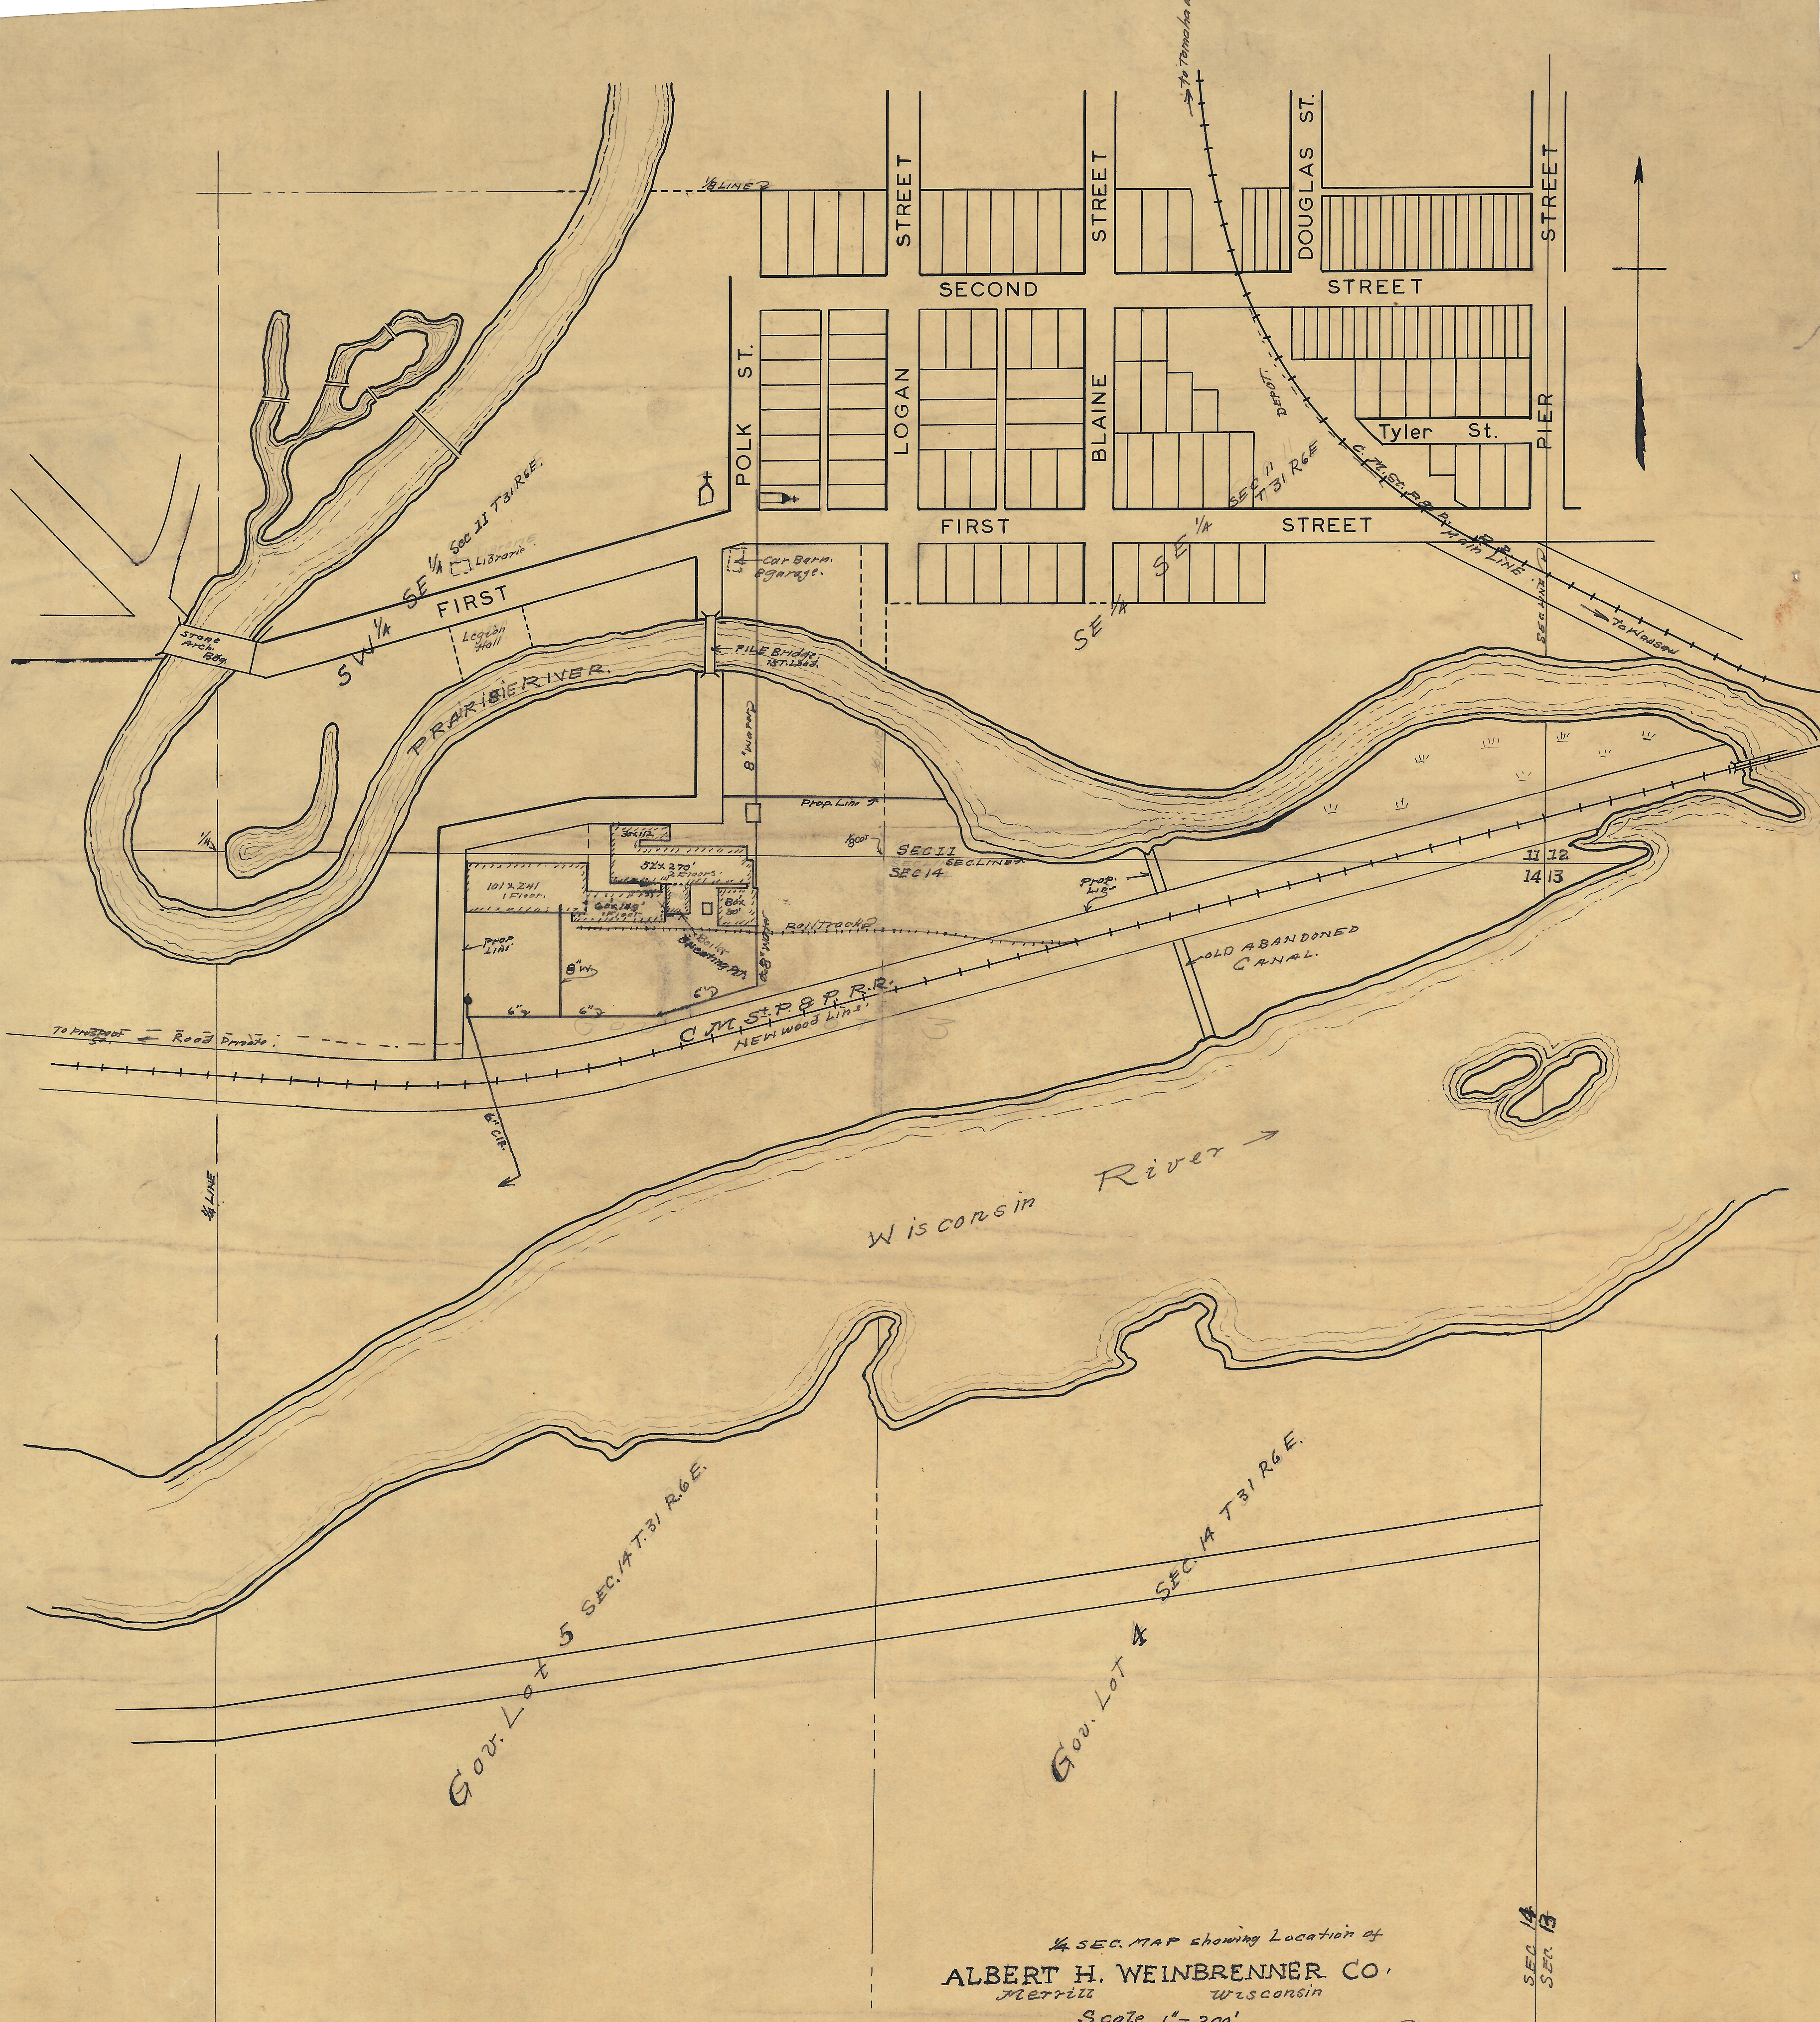

¼ SEC. MAP showing Location of

ALBERT H. WEINBRENNER CO.

Merrill Wisconsin

Scale 1" = 200'

H. C. Peterson.

Weinbrenner C-69

C-69